




**D1 1ST FLOOR PLAN**  
1/4"=1'-0"

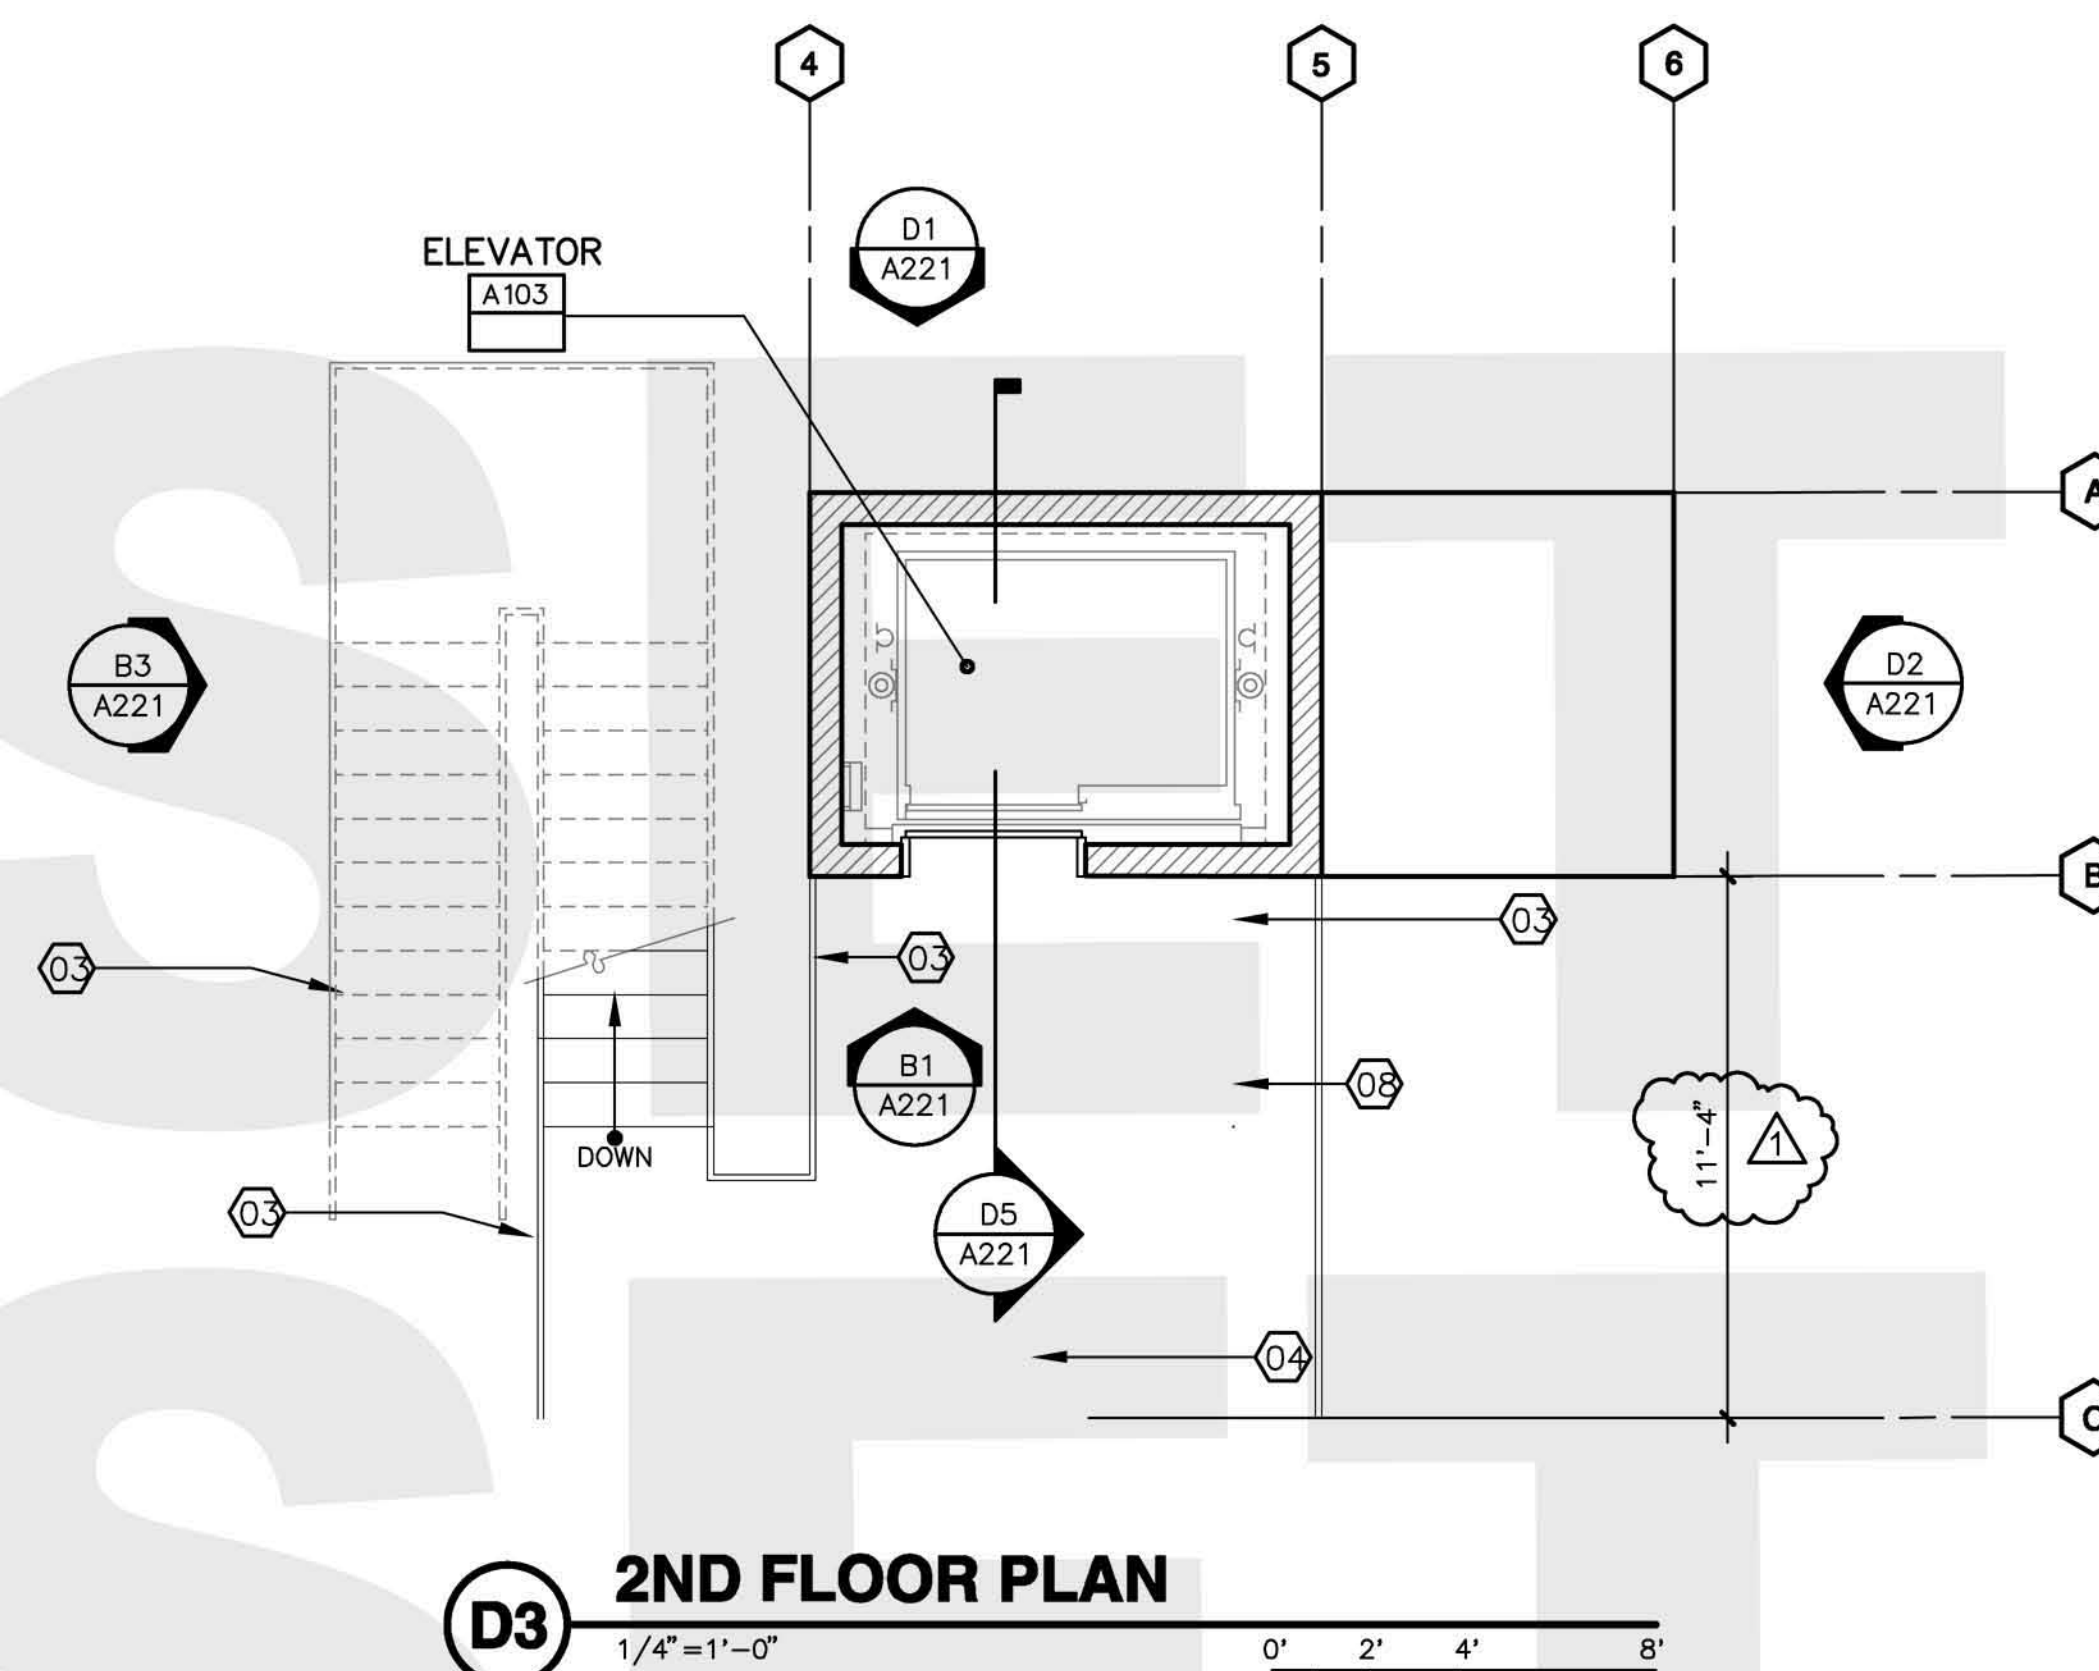


**D3 2ND FLOOR PLAN**  
1/4"=1'-0"

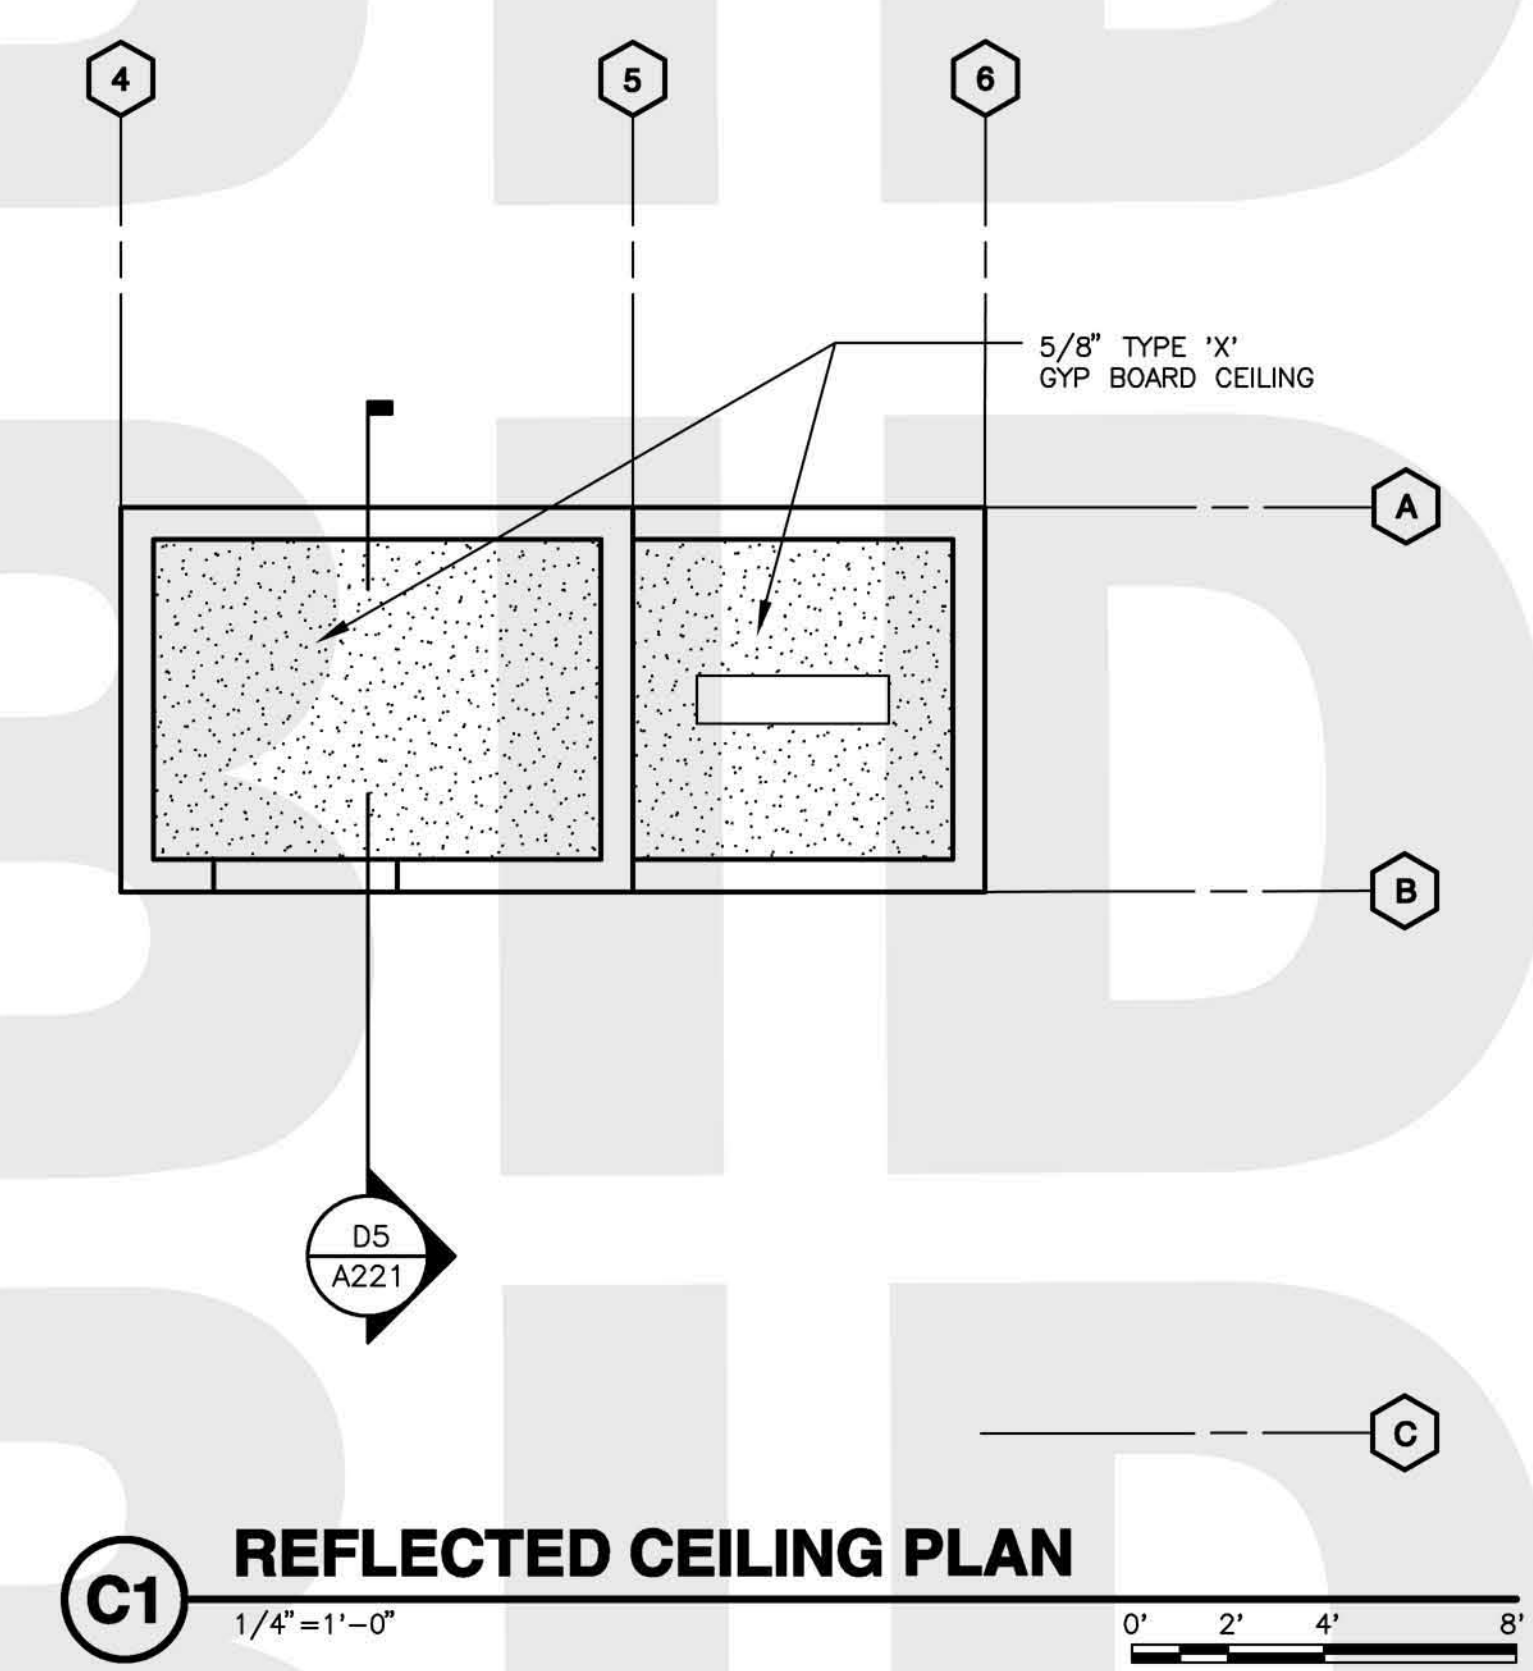


**C1 REFLECTED CEILING PLAN**  
1/4"=1'-0"

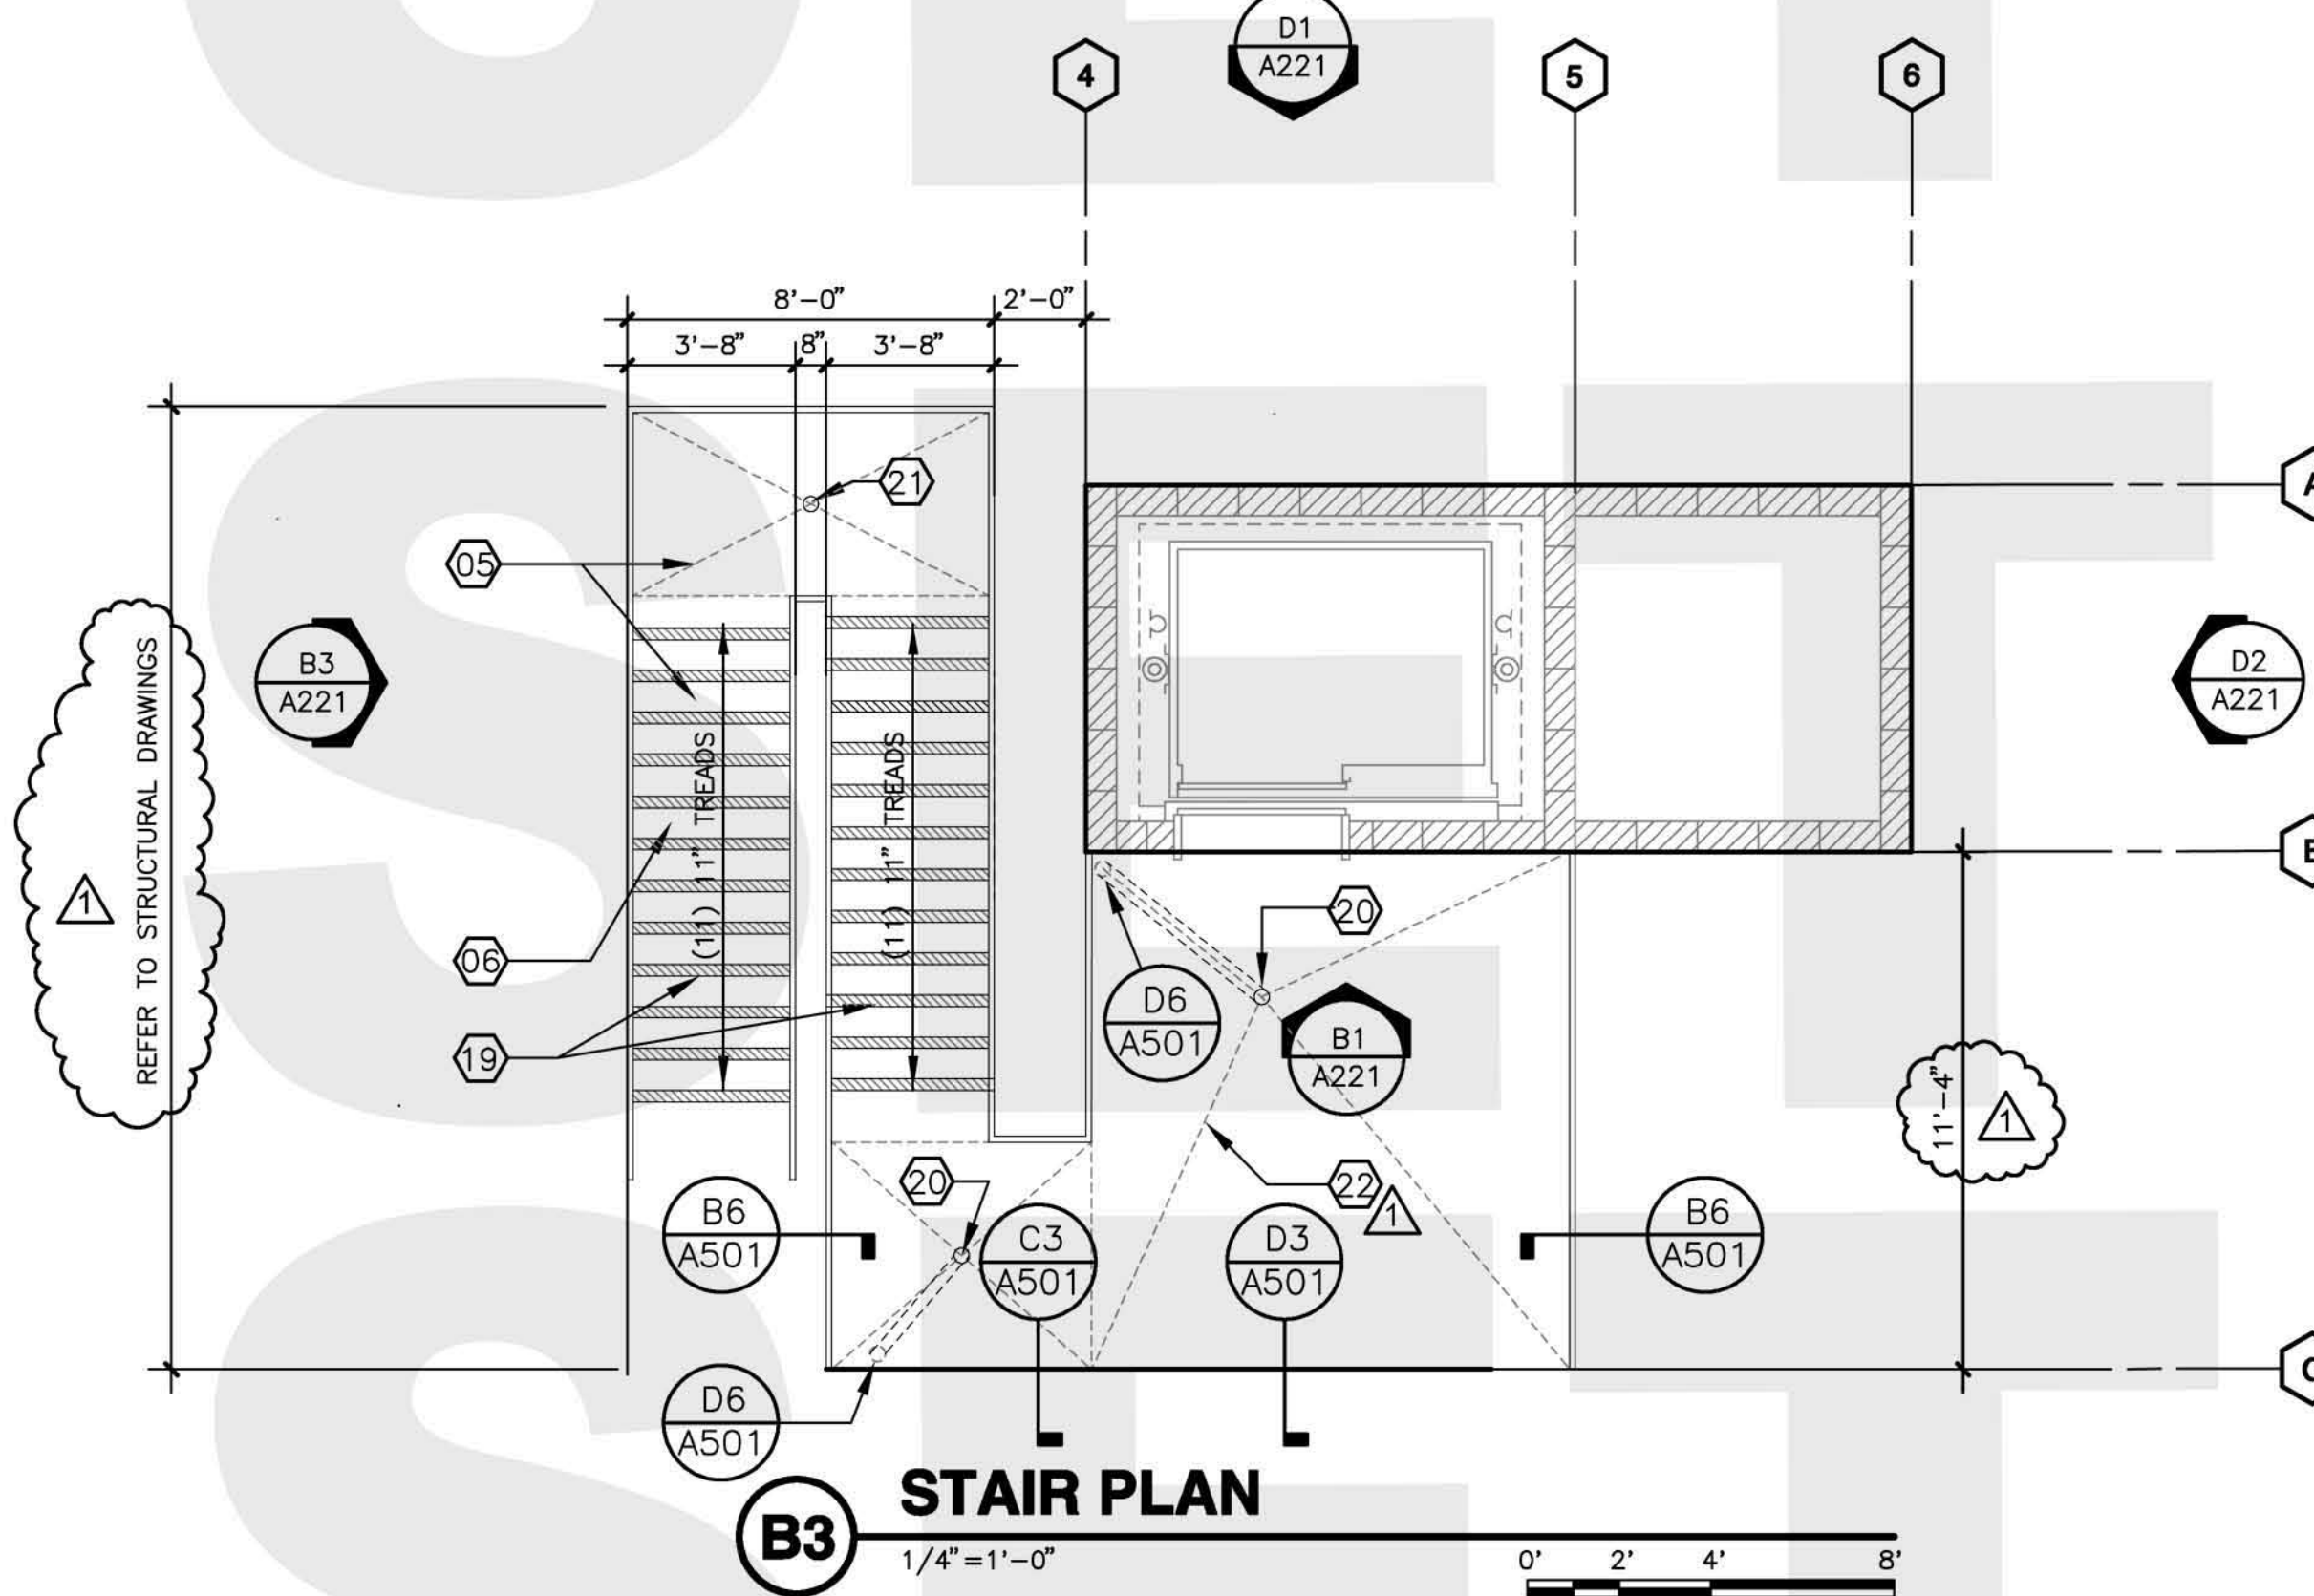

**B3 STAIR PLAN**  
1/4"=1'-0"

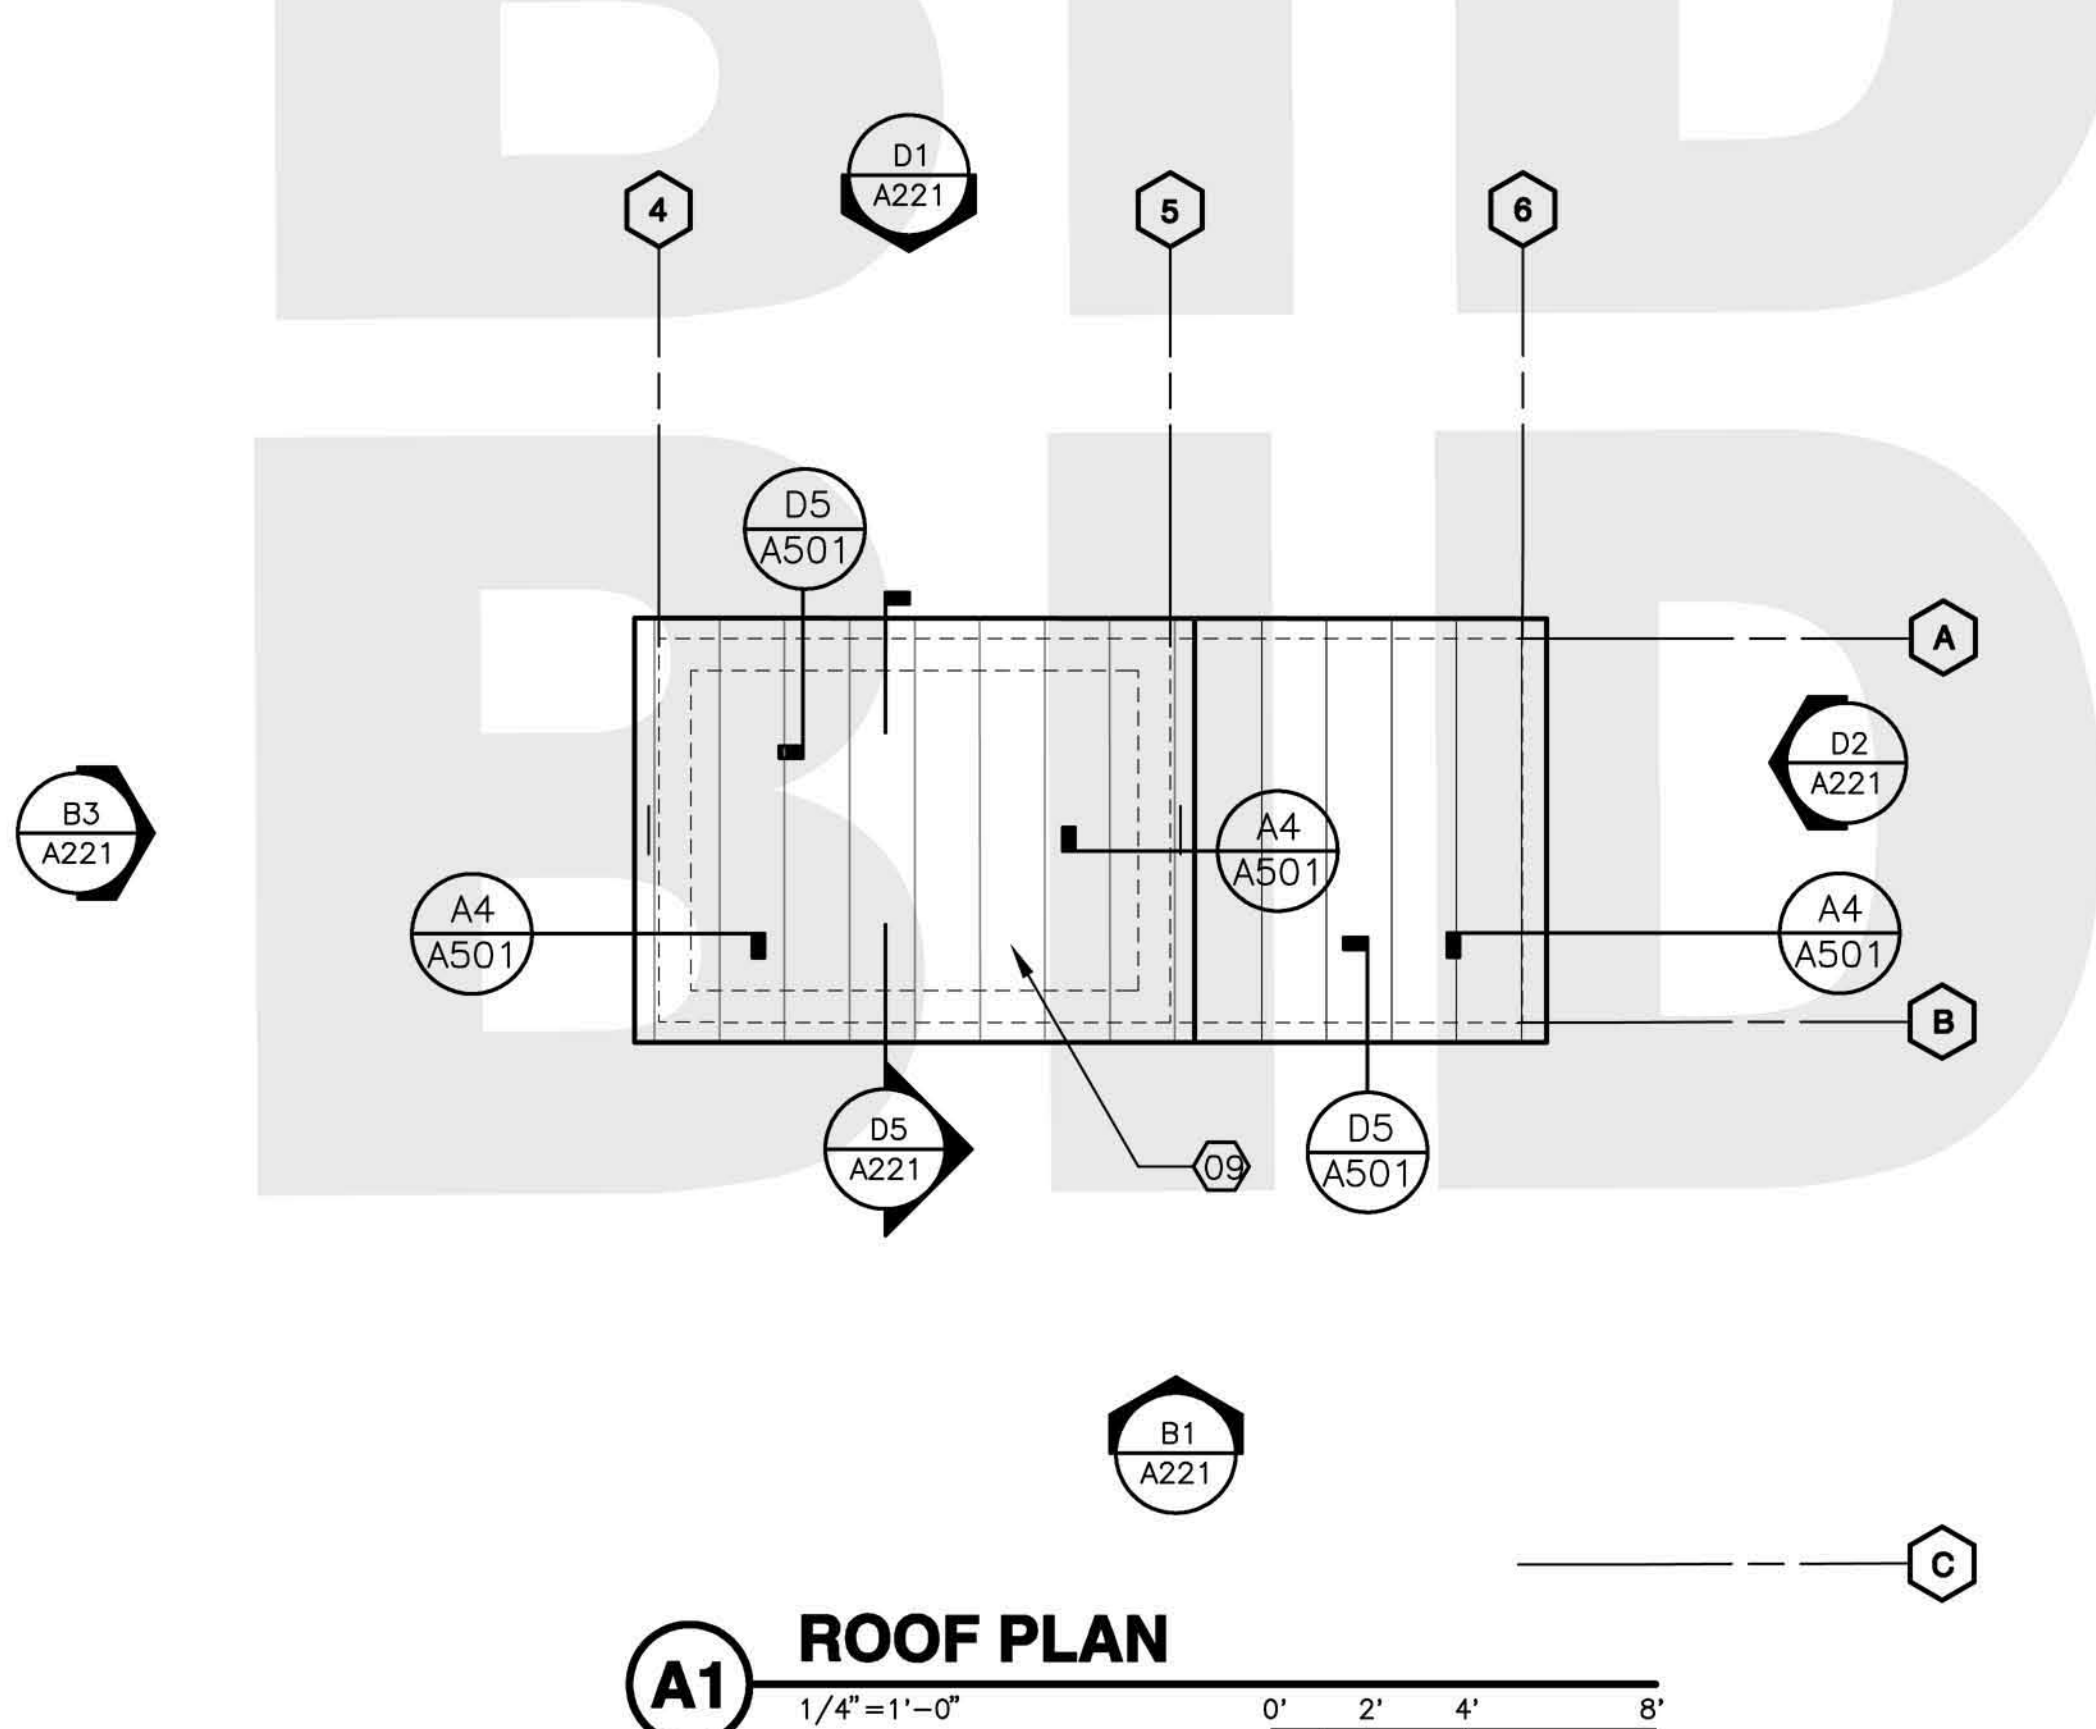


**A1 ROOF PLAN**  
1/4"=1'-0"

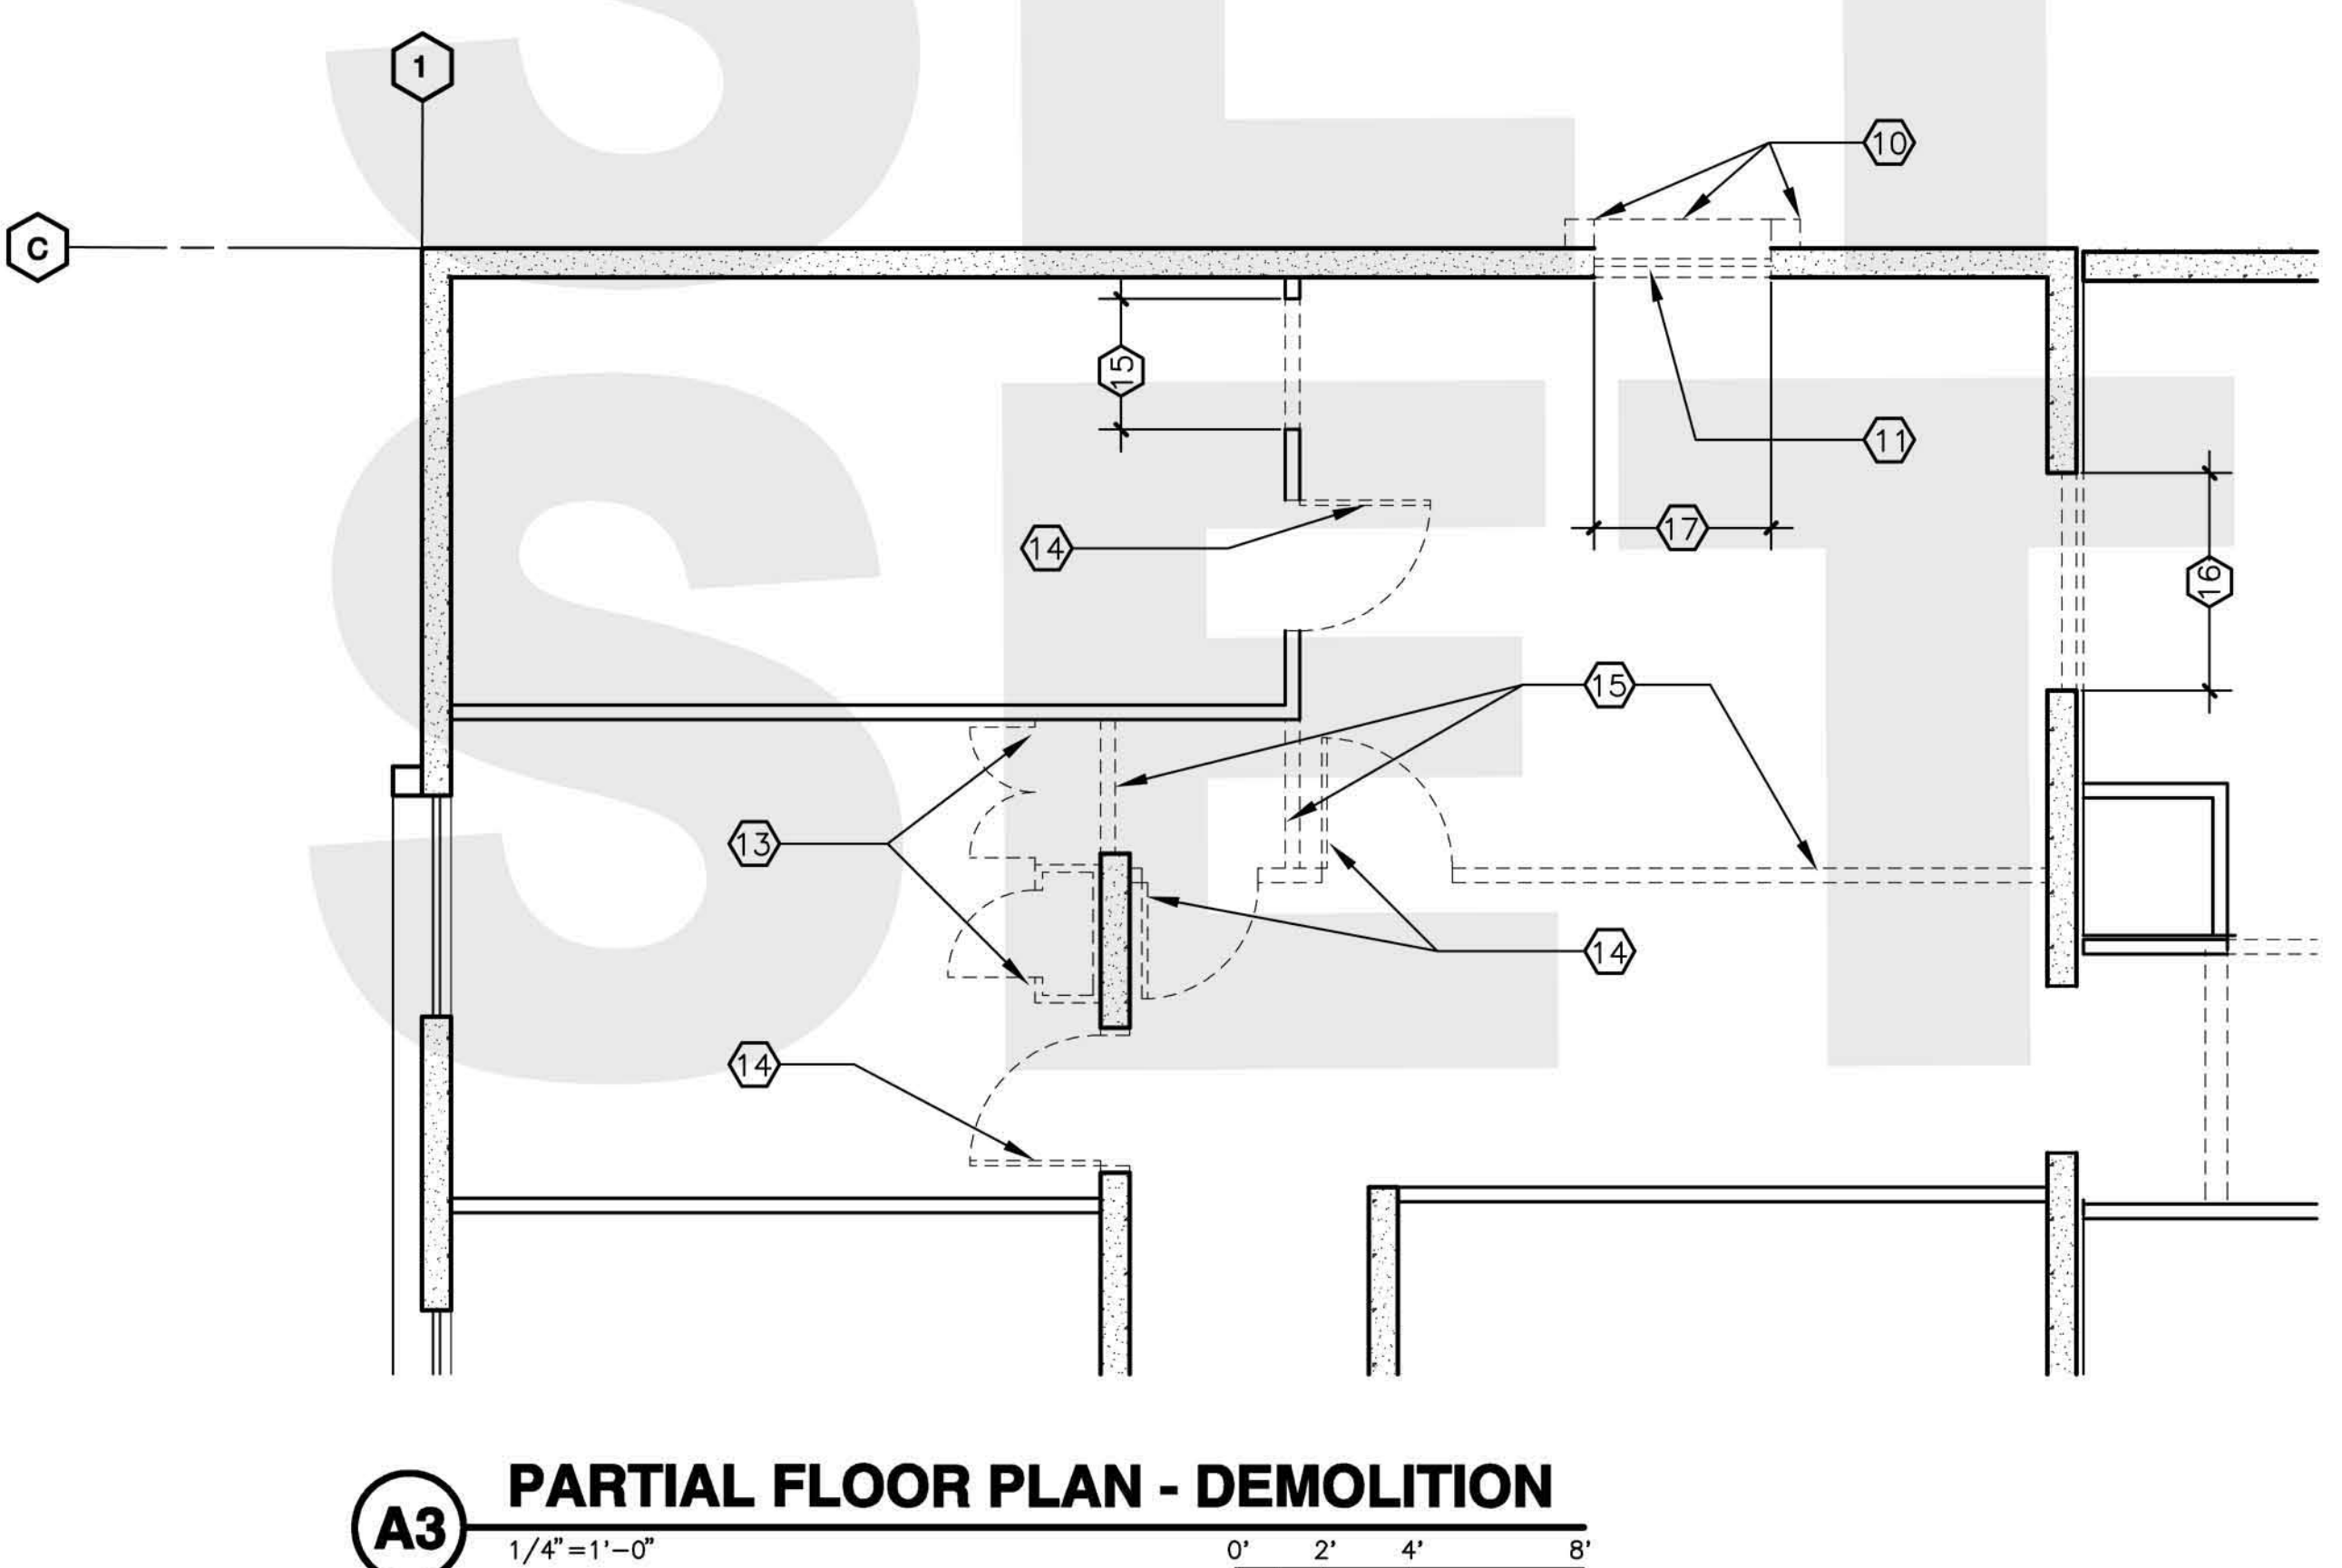

**A3 PARTIAL FLOOR PLAN - DEMOLITION**  
1/4"=1'-0"

**KEYNOTES**  
THIS SHEET ONLY

- 01 ELEVATOR PIT STAIR PER MANUFACTURERS REQUIREMENTS
- 02 ELEVATOR:  
MANUFACTURER: THYSSEN KRUPP  
MODEL: AMEE 30 HLS TWIN POST LH  
PROVIDE SUMP - SEE DETAIL E3, SHEET 501
- 03 1 1/2" DIAMETER PIPE GUARDRAIL
- 04 CONCRETE FILL ON GALVANIZED STEEL DECK
- 05 CONCRETE FILL / GALVANIZED PAN TREAD, RISER & LANDING
- 06 2" WIDE CONTRASTING COLOR STRIPING AT EACH TREAD
- 07 6" METAL STUD FURR OUT WITH EXTERIOR PLASTER
- 08 GUTTER & DOWNSPOUT
- 09 METAL ROOF:  
MANUFACTURER: AEP SPAN  
MODEL: CURVED SELECT SEAM 24 GAUGE  
NARROW BATTEN - 16 1/4" COVERAGE
- 10 EXISTING WINDOW FURRING TO BE REMOVED
- 11 EXISTING WINDOW SYSTEM TO BE REMOVED
- 12 EXTENT OF DEMOLITION FOR 3070 DOOR OPENING. FIELD VERIFY REQUIRED OPENING SIZE
- 13 EXISTING CASEWORK TO BE REMOVED
- 14 EXISTING DOOR TO BE REMOVED
- 15 EXISTING WALL TO BE REMOVED
- 16 EXISTING WALL INFILL TO BE REMOVED
- 17 EXTENT OF EXISTING WALL DEMOLITION BELOW WINDOW SILL
- 18 2X2 HAZARD RAIL AT +27" ABOVE FINISH CONCRETE SLAB AT GRADE SEE EXTERIOR ELEVATIONS
- 19 NOSING TREAD - SEE DETAIL B5, SHEET A501
- 20 8 1/2" CAST IRON DECK DRAIN TO 4" DRAIN LEADER. SLOPE CONCRETE DECK 1/8":1'-0" MINIMUM TO DRAIN
- 21 DECK DRAIN: NO DOWNSPOUT. SLOPE CONCRETE DECK 1/8":1'-0"
- 22 WARP LINES - TYPICAL
- 23 24"x24" ATTIC VENT - TYPICAL OF 2 SEE EXTERIOR ELEVATIONS

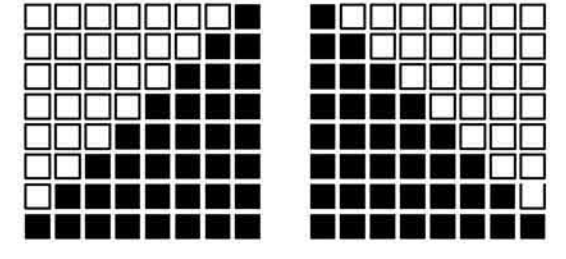

**ORDIZ MELBY**  
ARCHITECTS, INC.

5500 MING AVENUE SUITE 280  
BAKERSFIELD, CALIFORNIA 93309  
TELEPHONE (861) 832-5258  
FACSIMILE (861) 832-4291



DANNY E. ORDIZ, AIA  
ARCHITECT C-14728  
WILLIAM J. MELBY, AIA  
ARCHITECT C-16835  
CONSULTANT

**ELEVATOR BUILDING ADDITION FOR:**  
**AJITPAL TIWANA M.D.**

**2700 'F' STREET BAKERSFIELD, CALIFORNIA 93301**

**NOT FOR CONSTRUCTION**

MARK	DATE	DESCRIPTION
SD		
CD	11/12/2008	COB PLAN CHECK SUBMITTAL
Δ	03/02/2009	COB PLAN CHECK RESUBMITTAL

**AREA CALCULATION FOR VENTILATION AT HOISTWAY Δ**

AREA OF HOISTWAY = 62 SF  
3.5% OF 62 SF = 2.17 SF  
(3 SF OF FREE AIR MOVEMENT REQUIRED MINIMUM)  
VENTILATION AREA REQUIRED = 3 SF

VENTILATION PROVIDED = (2) 24"x24" WALL VENTS AT 1.73 SF FREE AIR VENTILATION  
VENTILATION AREA PROVIDED = (2) X 1.73SF = 3.46 SF

JOB NUMBER:  
**2004759.02**  
CAD DRAWING FILE:  
**2004759.02\DRAWINGS\CDA-122.AEC**  
DRAWN BY:  
**RR**  
CHECKED BY:  
**LA**  
CHECK AND VERIFY ALL DIMENSIONS BEFORE PROCEEDING WITH THE WORK. REPORT DISCREPANCIES TO THE ARCHITECT.  
THE DRAWINGS, IDEAS, AND DESIGNS REPRESENTED ON THIS SHEET ARE THE PROPERTY OF THE ARCHITECT.  
COPYRIGHT:  
ORDIZ-MELBY ARCHITECTS, INC. 2008

SHEET TITLE  
**FLOOR PLANS  
REFLECTED CEILING PLANS  
ROOF PLAN  
STAIR PLAN**  
SHEET IDENTIFICATION NUMBER

**A-122**  
SHEET 05 OF 07